



CRAFT MEDICAL PLAZA AN OFFICE CONDOMINIUM

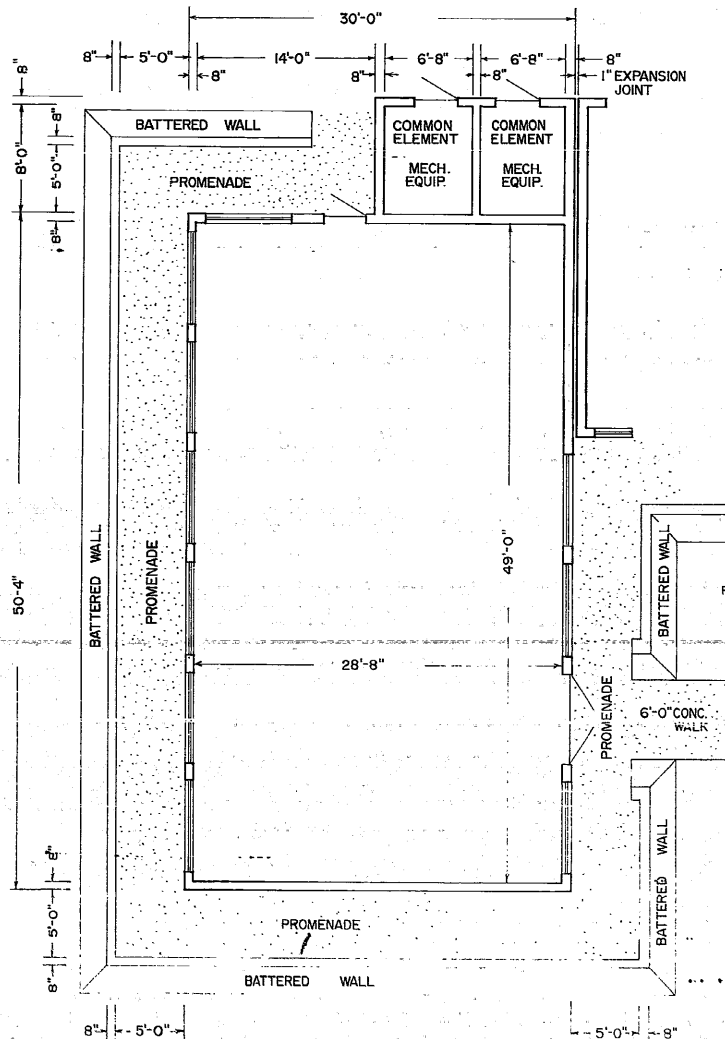

UNIT C FLOOR PLAN

SCALE 3/16" = 1'-0"

NOTE: INSIDE DIMENSIONS ARE AS-BUILT DIMENSIONS
AND TAKEN FROM UNFINISHED INTERIOR WALLS.

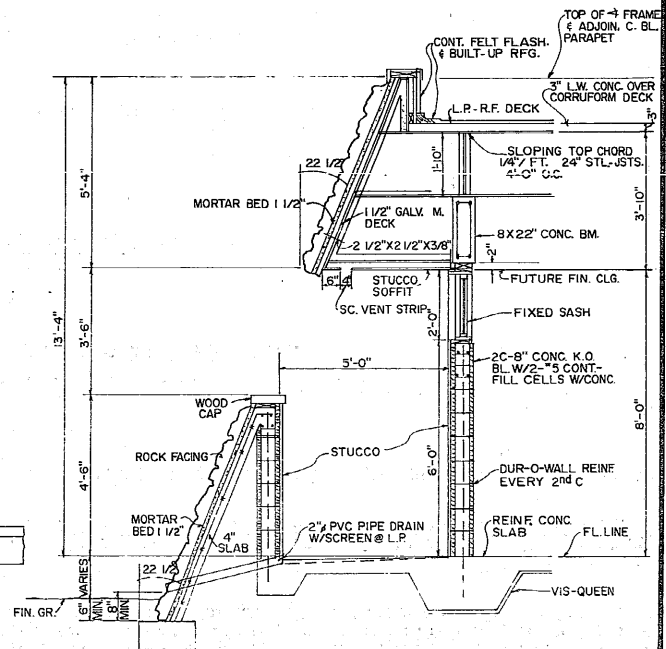

TYPICAL WALL DETAIL

SCALE: 1/2" = 1'-0"